

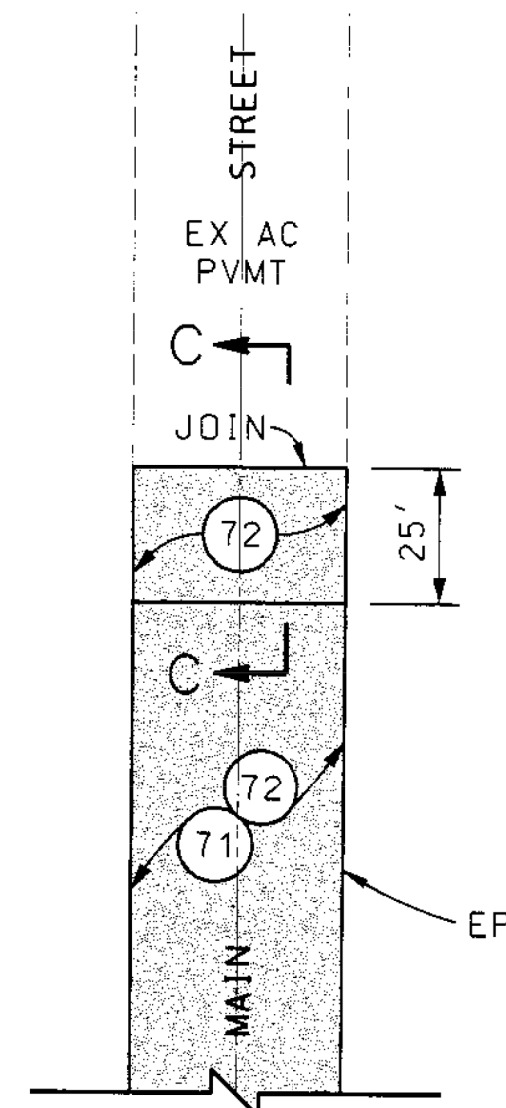


SIDE STREET JOIN DETAILS
NO SCALE

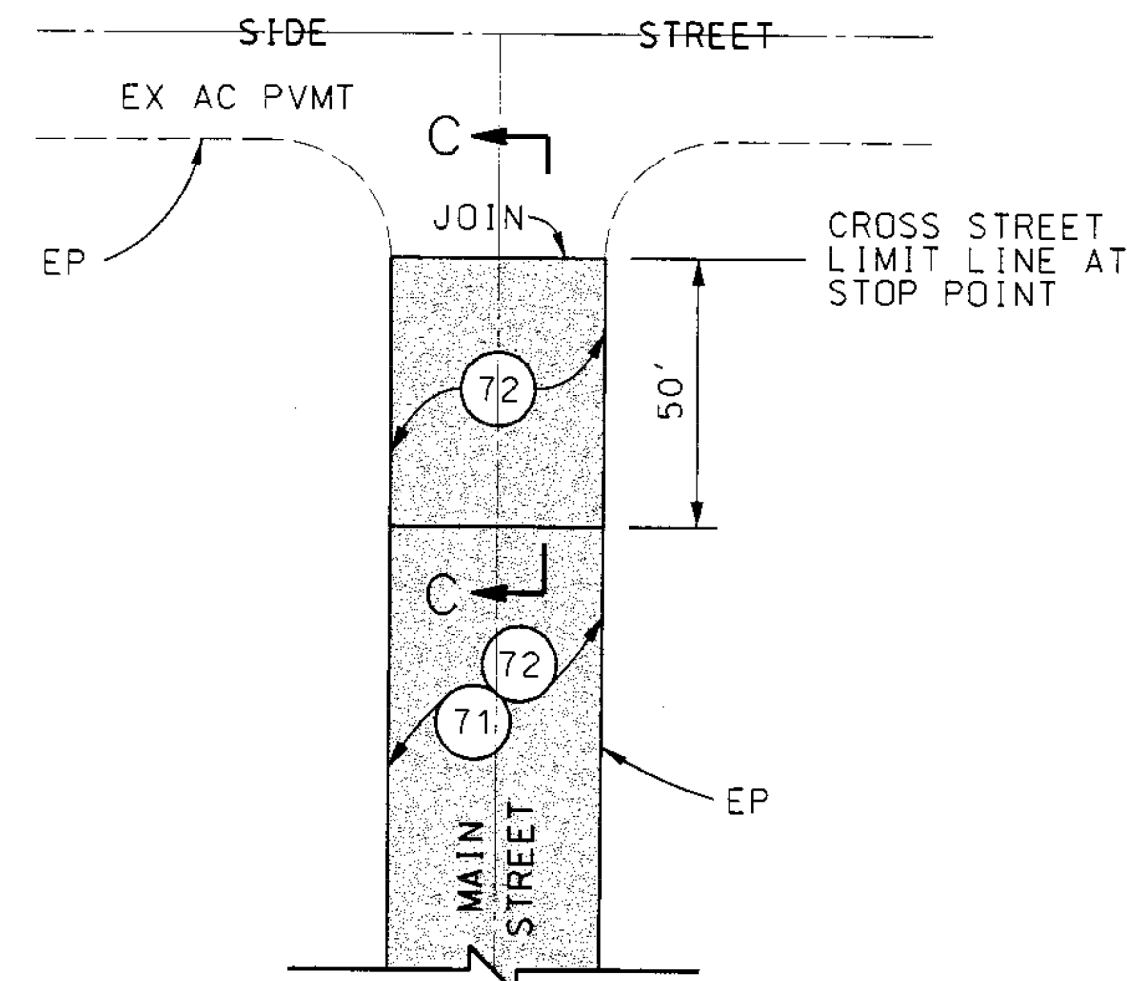


TYPICAL JOIN DETAIL
NO SCALE

CROSS STREET JOIN DETAIL
CORNELL ROAD @ MULHOLLAND HIGHWAY
LAS FLORES CANYON ROAD @ RAMBLA PACIFICO
RAMBLA PACIFICO @ PIUMA ROAD
SADDLE PEAK ROAD @ TUNA CANYON ROAD
NO SCALE

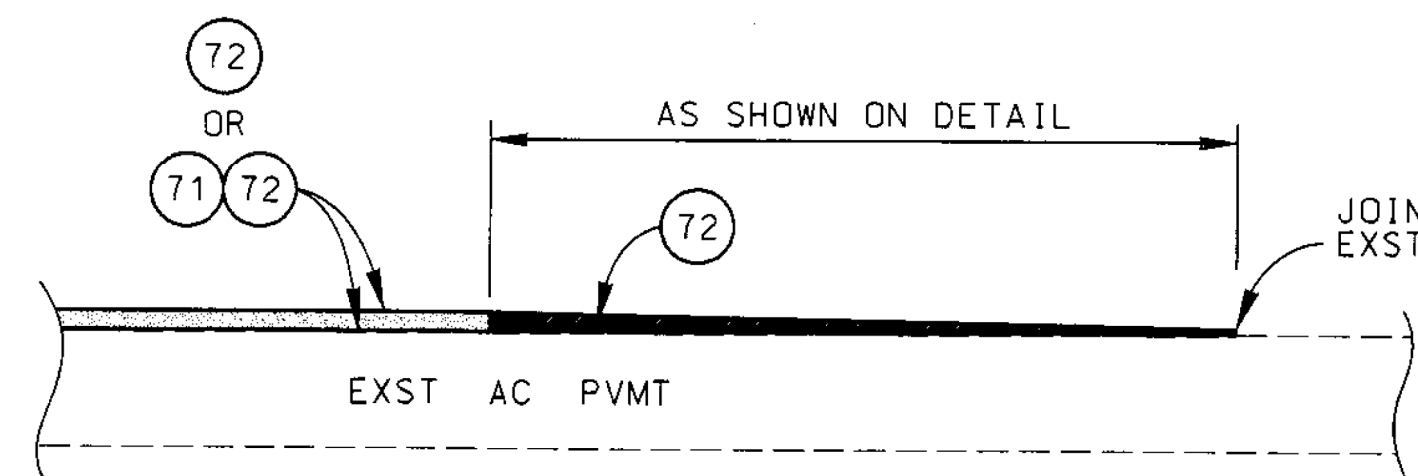


SECTION C-C
NO SCALE


* REMOVE EXISTING AC PAVEMENT TO BASE OR NATIVE SOIL. COMPACT BASE OR NATIVE SOIL. AND REPAVE DIGOUT AREA WITH SAME AC THICKNESS.

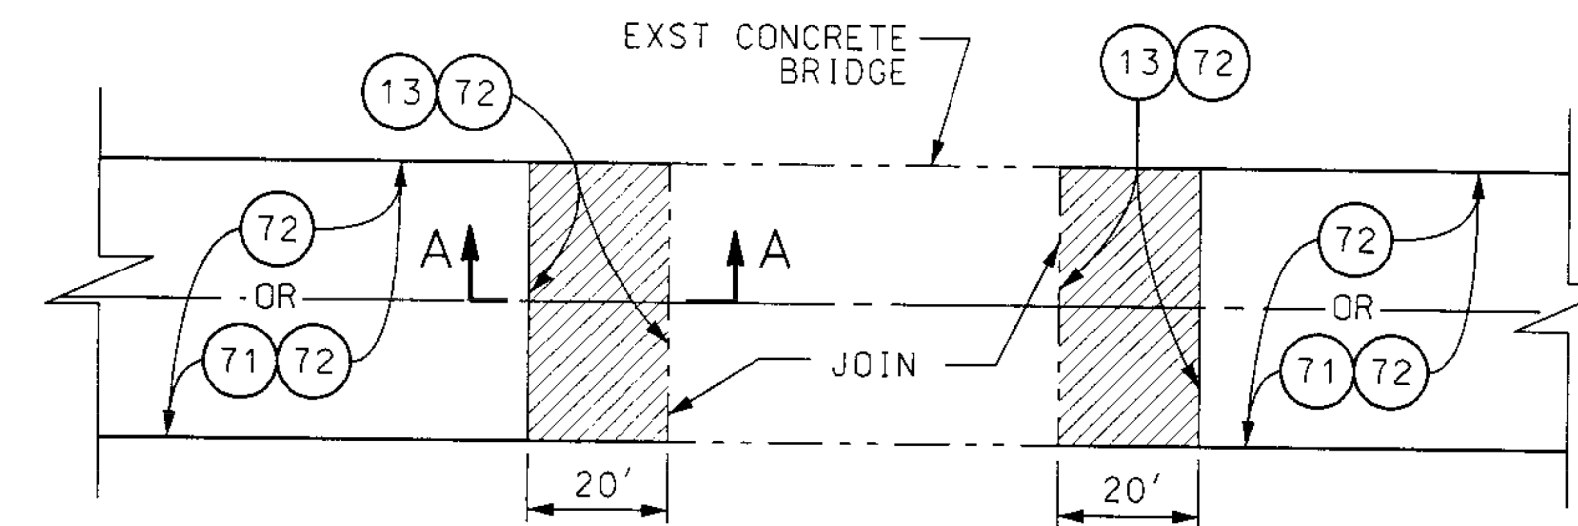


TYPICAL JOIN DETAIL FOR CONCRETE BRIDGES
OLD TOPANGA CANYON ROAD: BRIDGES #758 AND #759
NO SCALE

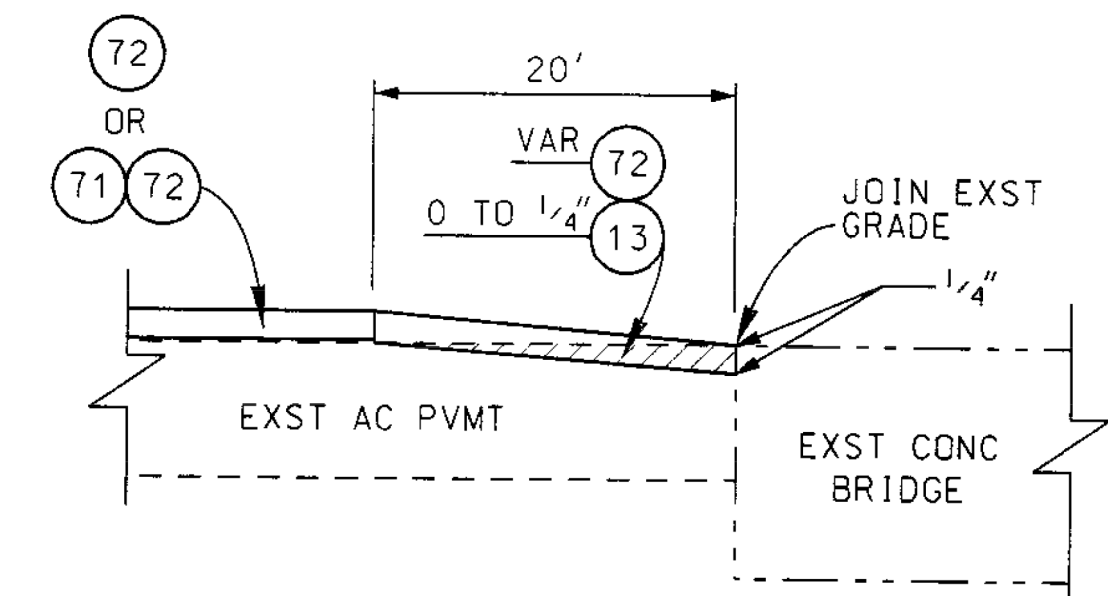

SECTION A-A
TYPICAL BOTH ENDS
NO SCALE

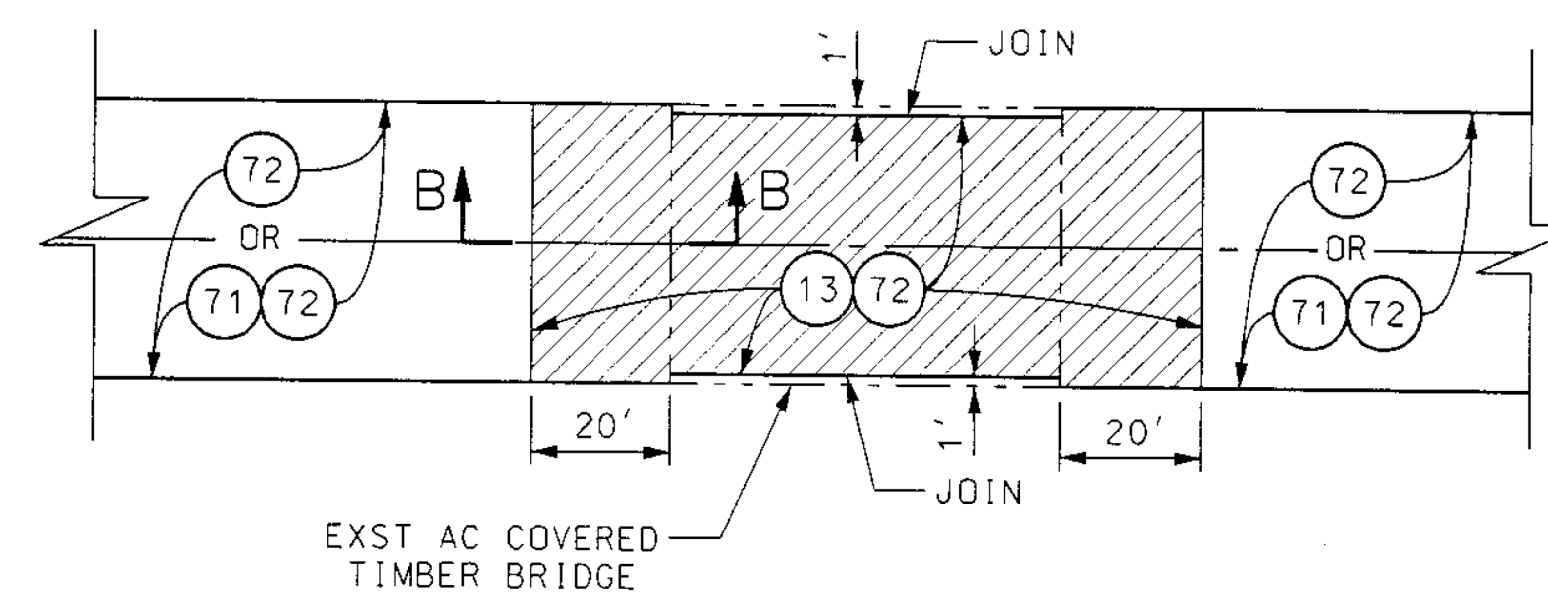

TYPICAL JOIN DETAIL FOR AC COVERED BRIDGES
OLD TOPANGA CANYON ROAD: BRIDGES #423, #503, #567, AND #750
NO SCALE

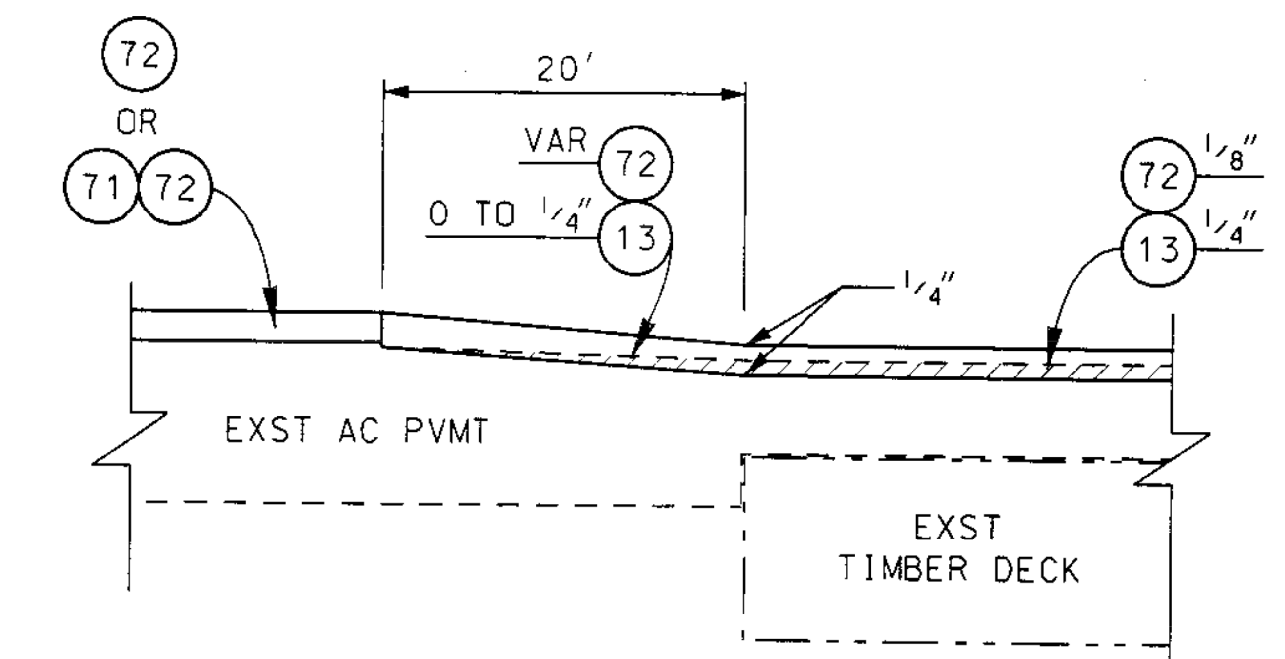


SECTION B-B
TYPICAL BOTH ENDS
NO SCALE



DIGOUT TABLE* & ADDITIONS PER C.O. #1			
SEGMENT	LOCATIONS	DIMENSIONS (L X W)	DEPTH
FERNWOOD PACIFIC DRIVE	AT MILE MARKER 0.40	7' X 20'	10"
LAS FLORES CANYON ROAD	N/O COUNTY OF LOS ANGELES / CITY OF MALIBU BOUNDARY	40' X 12'	6"
	AT MILE MARKER 1.11	11' X 30'	
	AT MILE MARKER 1.63	11' X 75'	
	AT MILE MARKER 2.04	5' X 75'	
	AT HUME ROAD	11' X 275'	
OLD TOPANGA CANYON ROAD	AT RAMBLA PACIFICO	10' X 25'	7" - 12"
	N/O MILE MARKER 6.12 NEAR HN 282	12' X 24'	
	AT MILE MARKER 2.37, N/O HN 2623	35' X 5'	
RAMBLA PACIFICO	S/O HUME ROAD	22' X 7'	7" - 9"
	NEAR INTERSECTION WITH LAMPLIGHTER LANE, ACROSS FROM HN 21901	5' X 36'	
	N/O MILE MARKER 2.27, S/O HUME ROAD	38' X 24'	
	AT MILE MARKER 0.30, ROADWAY DEPRESSION	4' X 4'	
SADDLE PEAK ROAD	AT MILE MARKER 0.69	10' X 10'	5" - 6"
	S/O MILE MARKER 1.80, N/O SWENSON DRIVE	50' X 9'	
TUNA CANYON ROAD	AT MILE MARKER 0.14	4' X 12'	6"

DATE	BY	DESCRIPTION
12/28/09	BB	ADDED DIGOUT ON TUNA CANYON ROAD.
REVISIONS		

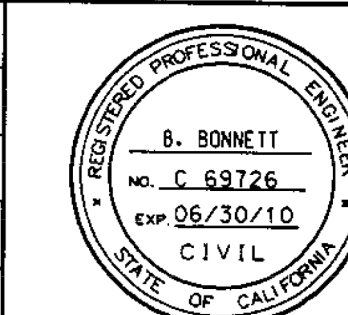

COUNTY OF LOS ANGELES DEPARTMENT OF PUBLIC WORKS
LAS FLORES CANYON ROAD, ET AL.
TYPICAL SECTIONS AND DETAILS
PROJECT ID NO. RDC0014946

PCA X2301491 DWG PH078532 SHEET 4 OF 4

AS BUILT DRAWINGS

DATE: 09/29/09
REVIEWED BY: [Signature]
CADD PROJECT FILE NAME: RDC0014946-PLAN-RO.DGN
CHECKER: W. LO.
DESIGNER: B. BONNETT
DRAFTER: B. BONNETT